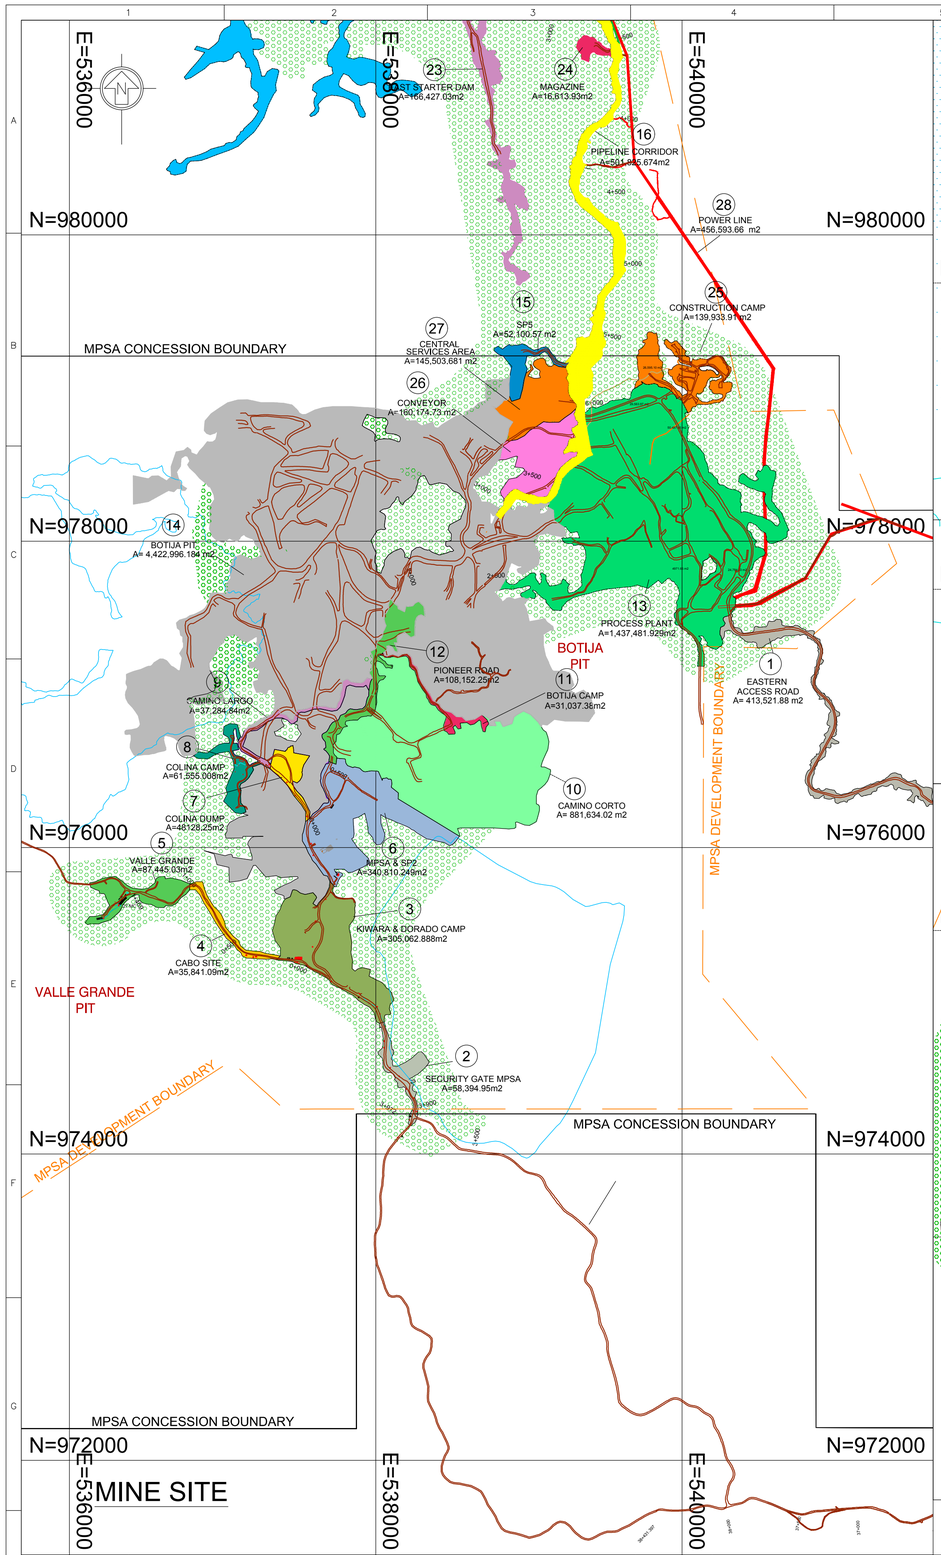

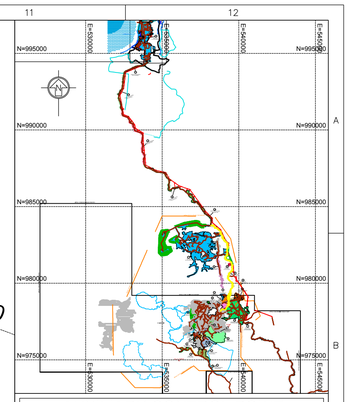

LEGEND

- ROAD
- POLYGON OF FOREST CLEARED
- POLYGON OF INFLUENCE OF WORKS
- MPSA CONCESSION BOUNDARY
- CONSERVATION AREA LIMIT

TABLE
POLYGON OF FOREST CLEARED

POLYGON	SITE	AREA
1	EASTERN ACCESS ROAD	41 Hect +3521.88 m2
2	SECURITY GATE MPSA	5 Hect +8394.95 m2
3	KIWARA & DORADO CAMP	30 Hect +5062.89 m2
4	CABO SITE	3 Hect +5841.09 m2
5	VALLE GRANDE	8 Hect +7445.03 m2
6	MPSA & SP2	34 Hect +0810.25 m2
7	COLINA DUMP	4 Hect +8128.25 m2
8	COLINA CAMP	6 Hect +1555.01 m2
9	CAMINO LARGO	3 Hect +7284.84 m2
10	CAMINO CORTO	88 Hect +1634.02 m2
11	BOTIJA CAMP	3 Hect +1037.38 m2
12	PIONEER ROAD	10 Hect +8152.25 m2
13	PROCESS PLANT	143 Hect +7481.93 m2
14	BOTIJA PIT	442 Hect +2996.18 m2
15	SP5	5 Hect +2100.57 m2
16	PIPELINE CORRIDOR	50 Hect +1825.67 m2
17	TMF AREA	442 Hect +2966.18 m2
18	COAST ACCESS ROAD	57 Hect +9449.13 m2
19	COAST ACCESS ROAD	27 Hect +1774.28 m2
20	PORT SITE	174 Hect +7375.66 m2
21	COAST ACCESS ROAD	25 Hect +7224.18 m2
22	EAST STARTER DAM	10 Hect +3412.32 m2
23	EAST STARTER DAM	16 Hect +6427.03 m2
24	MAGAZINE	1 Hect +6613.93 m2
25	CONSTRUCTION CAMP	13 Hect +9933.91 m2
26	CONVEYOR	16 Hect +0174.73 m2
27	CENTRAL SERVICES AREA	14 Hect +5503.68 m2
28	POWER LINE	45 Hect +6593.66 m2
	TOTAL	**1729 Hect +0720.88 m2**

NOTES:
1. ALL DIMENSIONS, ELEVATIONS AND GRID COORDINATES SHOWN ON THIS DRAWING ARE IN METERS. GRID SHOWN IS REFERENCED TO UTM WGS84 ZONE 17N DATUM.

PLAN VIEW AREA

400m 0 400 800 1200 1600m
GRAPHIC SCALE 1:20,000

Minera Panamá

RR	CA	AM				
DRAWN	CHECKED	DESIGN ENG.	LEAD ENG.	DESIGN APP'D	PROJ. APP'D	CLIENT APP'D

DRG No	REFERENCE DRAWINGS	REV	DATE	DESCRIPTION	DRN	CHK'D	DESIGN ENG.	LEAD ENG.	DESIGN APP'D	PROJ. APP'D	CLIENT APP'D

CLIENT MPSA
PROJECT MINA DE COBRE PANAMA
GENERAL PLAN

FIRST QUANTUM MINERALS LTD.

DRAWING TITLE
COBRE PANAMA PROJECT
FOREST CLEARED AREAS

THIS DRAWING IS THE PROPERTY OF MINERA PANAMA S.A (MPSA), AND THE USE AND COPYING THEREOF IS SUBJECT TO THE TERMS OF THE AGREEMENT UNDER WHICH IT WAS PREPARED. THIS DRAWING MAY NOT BE COPIED EXCEPT AS EXPRESSLY PROVIDED THEREIN.

ESTE PLANO ES PROPIEDAD DE MINERA PANAMA S.A (MPSA). SU USO Y REPRODUCCION ESTAN SUJETOS A LOS TERMINOS DEL CONTRATO BAJO EL CUAL FUE PREPARADO. PROHIBIDA SU REPRODUCCION A MENOS QUE SEA EXPRESAMENTE INDICADO.

SCALE	JOB No.	DRG No.	REV.
1:20,000	1824	916-DRG-6002	00

DRAWN JUAN MONTENEGRO
DATE 03 SET 2017

Format A1

5 September 2017 X:\TOPO_OFICINA\MPSA 2013\01 DATA\GENERAL PLAN PROJECT\02 DWG\03 AS BUILT\01 DWG\030917-POLYGON OF FOREST CLEARED-AB-JM.DWG